


VICINITY MAP
NTS

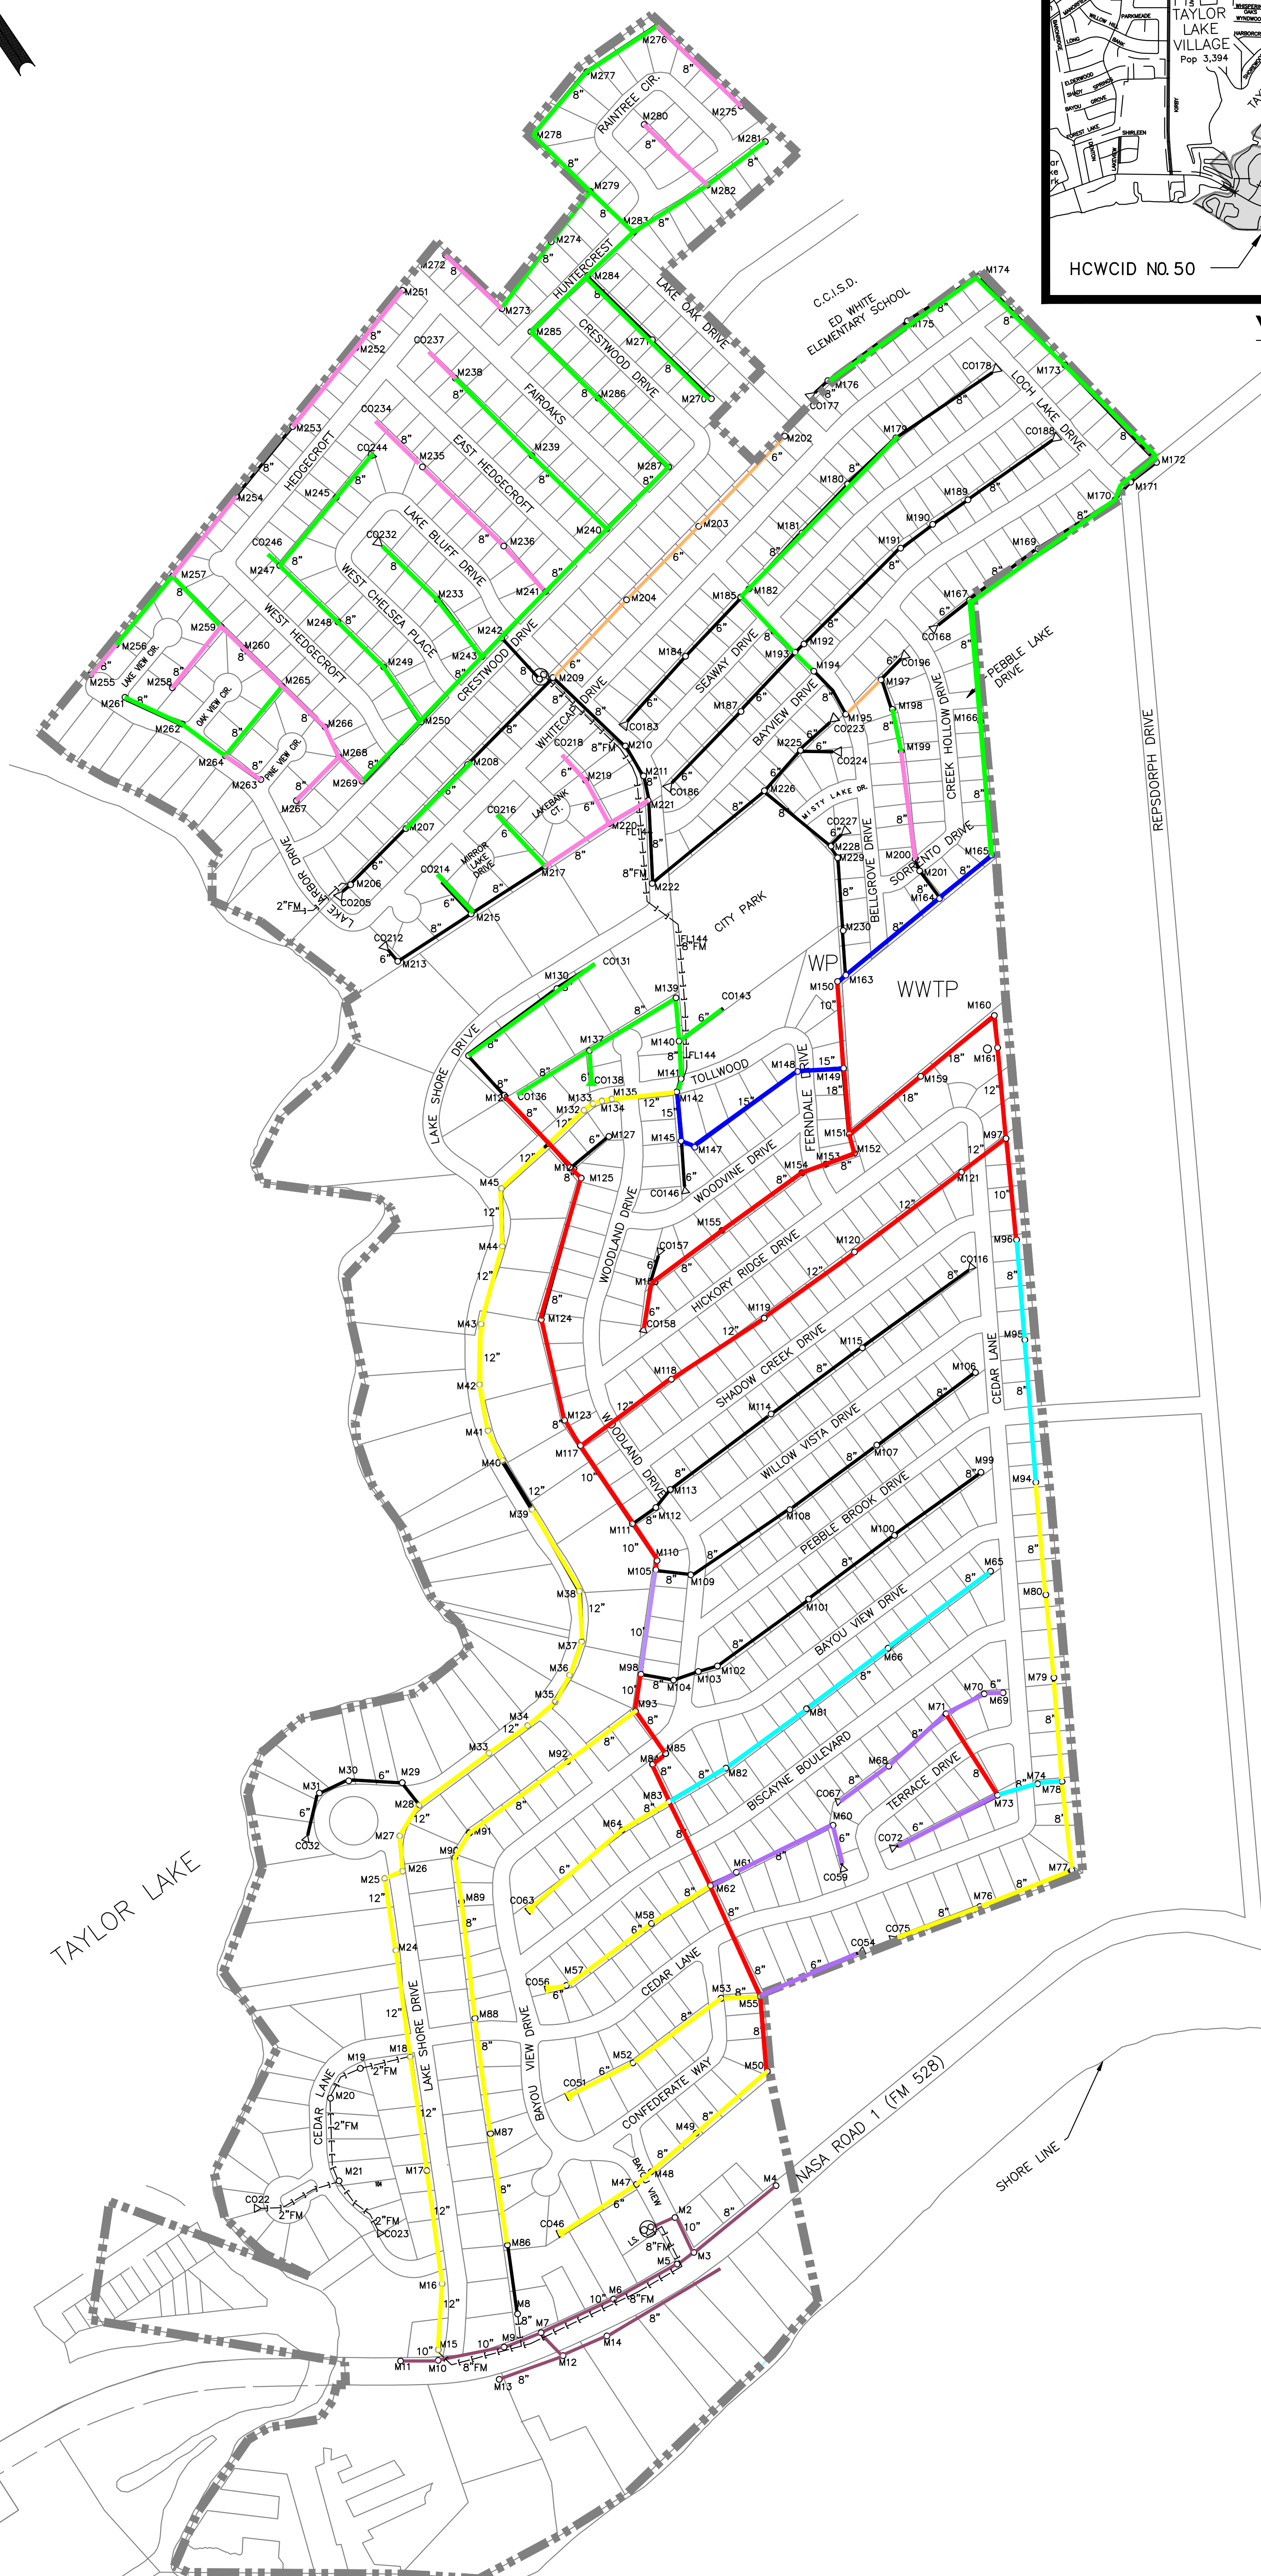

STATUS OF SANITARY SEWER REHABILITATION LEGEND

Red line	1977-78	SLIPLINED
Blue line	1986	CIPP
Orange line	1988	PIPEBURST
Purple line	1999	REPLACED TXDOT
Yellow line	2000-05	CIPP
Cyan line	2006	CIPP & PIPE BURST
Light blue line	2011	PIPE BURST
Green line	2016	PIPE BURST
Pink line	2016	CIPP

LEGEND

--- (dashed line)	DISTRICT BOUNDARY LINE
(thick line)	FORCE MAIN
⊙ (circle with dot)	SANITARY SEWER LIFT STATION
▷ (arrow)	SANITARY SEWER CLEANOUT
CO72	CLEAN OUT NUMBER
M60	SANITARY SEWER MANHOLE NUMBER

HARRIS COUNTY WCID NO. 50
SANITARY SEWER REHAB
SUMMARY - 2017

 10377 Stella Link Road
 Houston, TX 77025
 713 / 942 / 2700
 Texas Engineering Registration No. F-000802

SCALE 1"=300' MAY 2017